


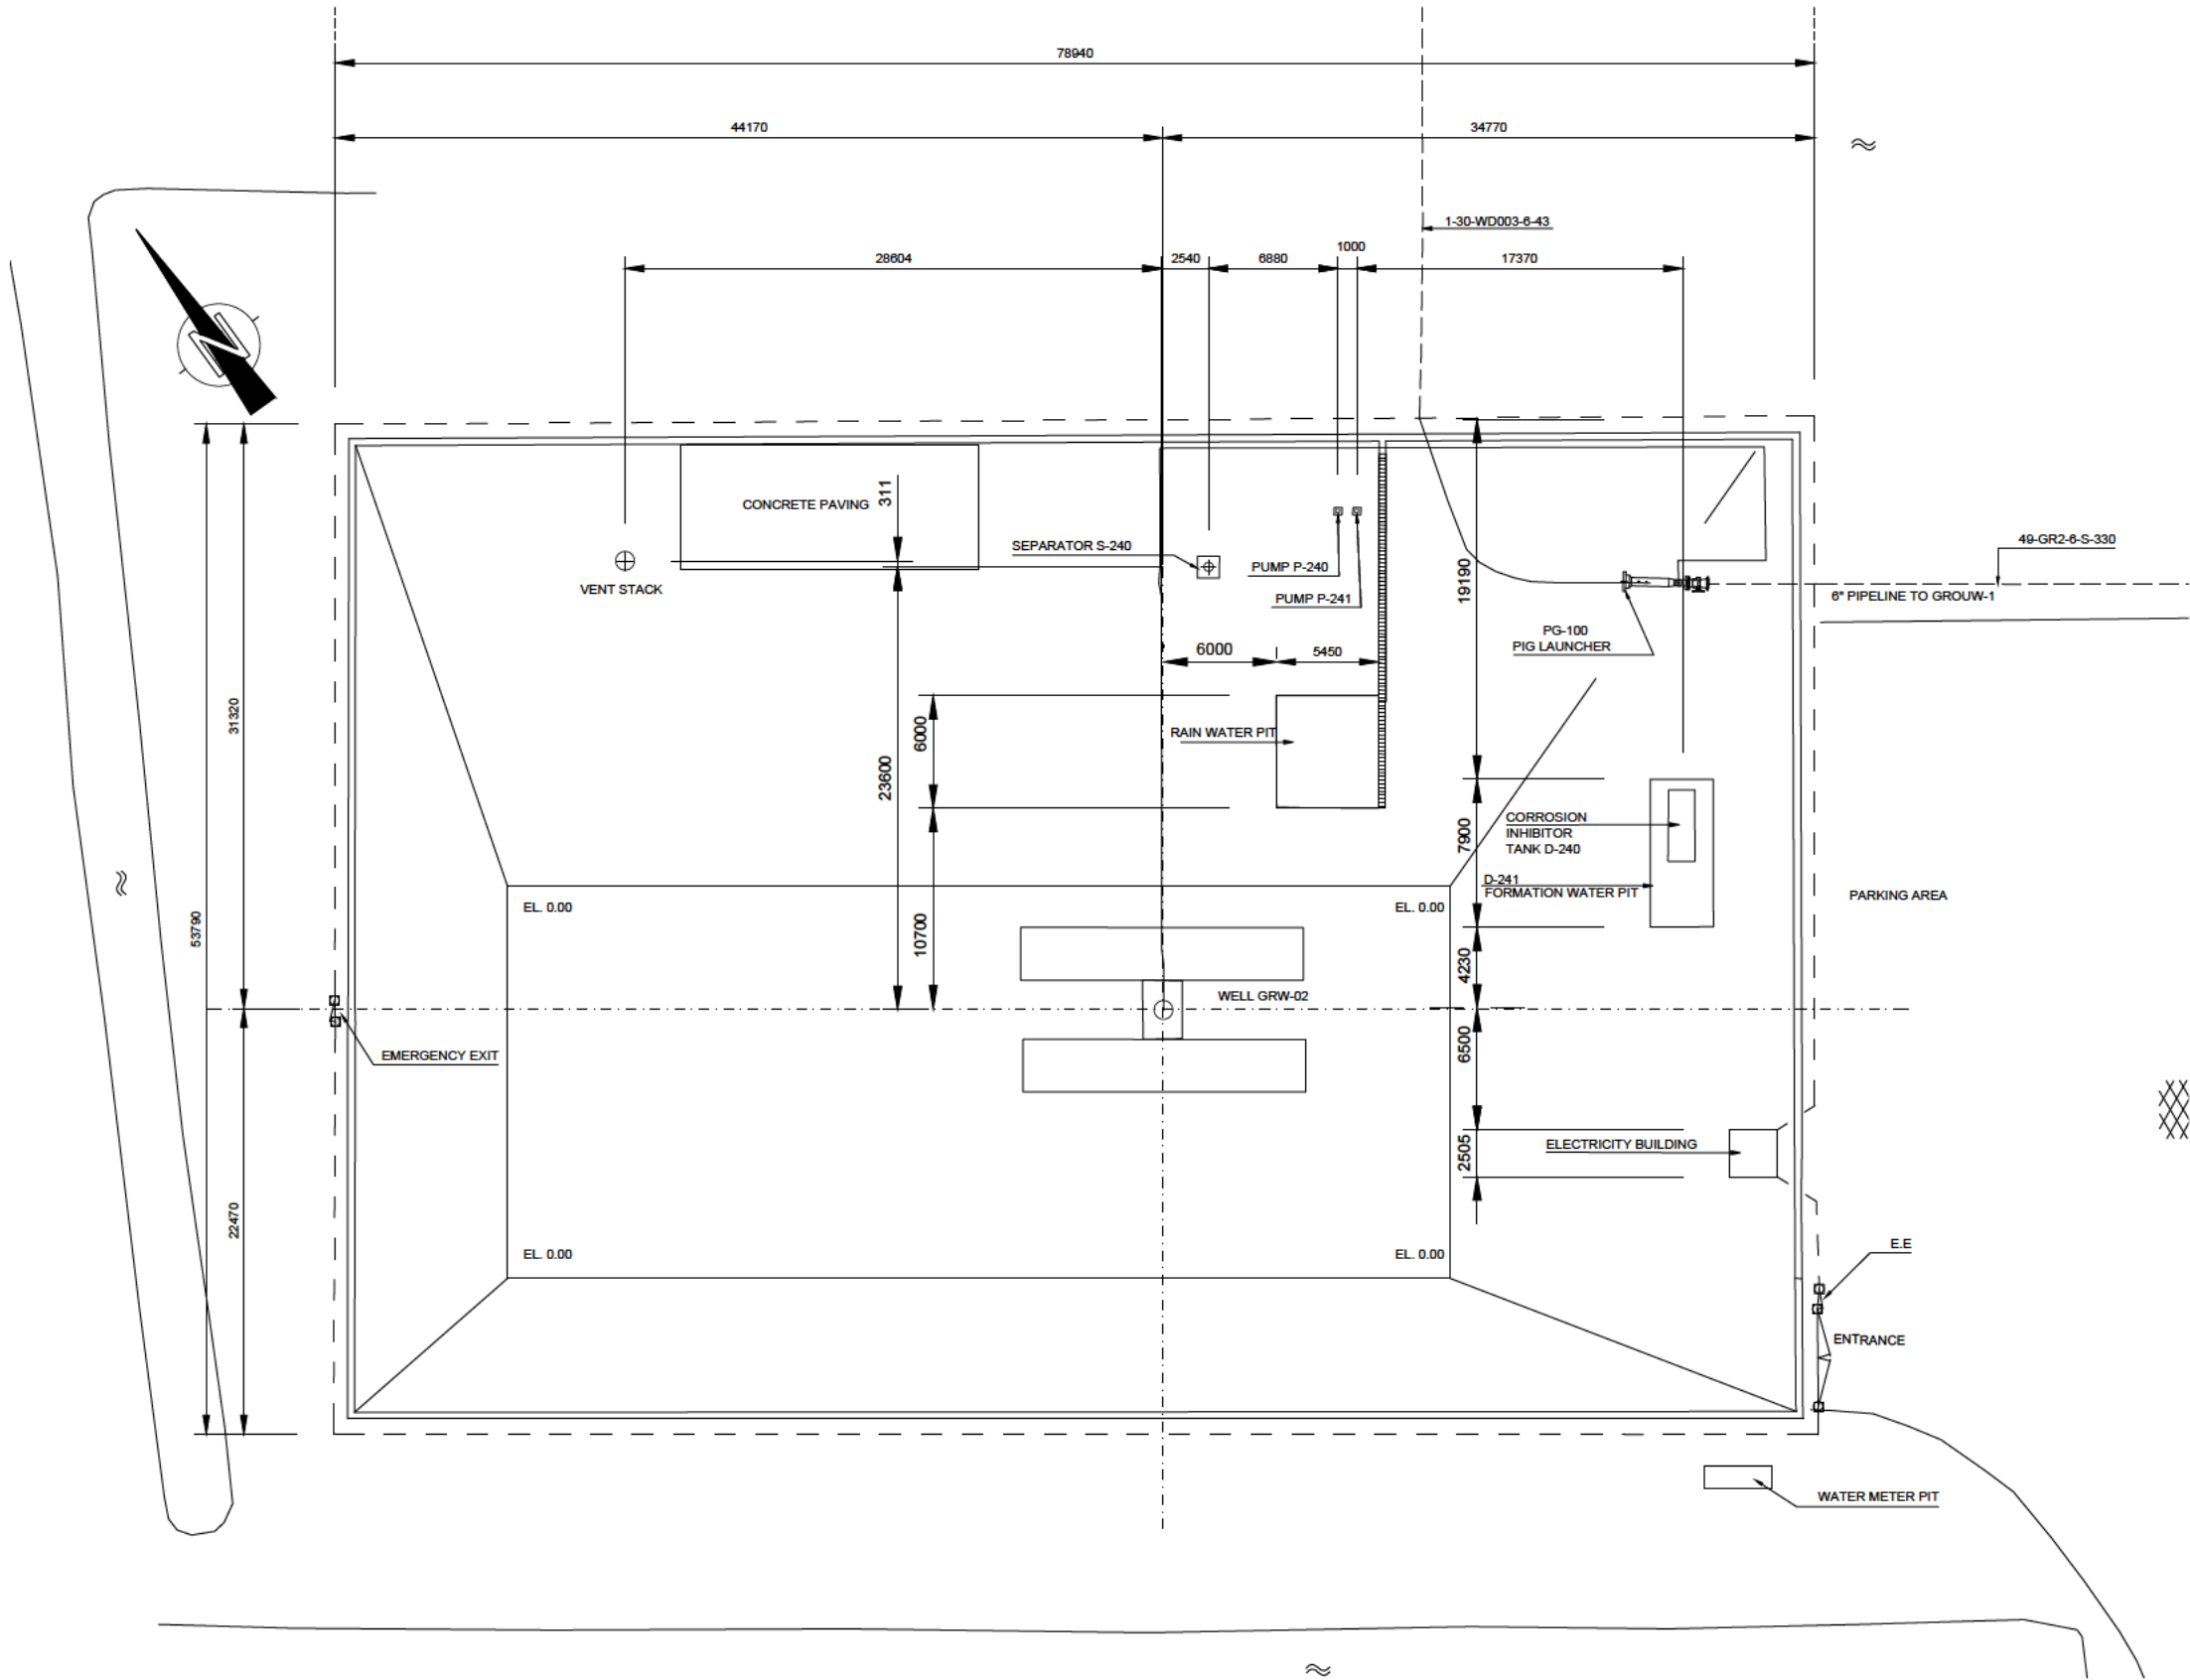

EQUIPMENT LIST		
ITEM	DESCRIPTION	DIMENSIONS
GRW-02	WELL GROUW 02	-
S-240	SEPARATOR	-
D-241	FORMATION WATER PIT	-
-	RAIN WATER PIT	-
D-240	GLYCOL TANK	-
-	VENT STACK	-
PG-100	PIG LAUNCHER	-
P-240	PUMP	-
P-241	PUMP	-
-	ELECTRICITY BUILDING	-

GENERAL NOTES

1.

HOLDS

REFERENCE DRAWINGS

 
LEGEND

- GAS PIPELINE (under ground)
- GAS PIPELINE (above ground)
- VENTILATION PIPE
- OTHER PIPELINES
- CABLE DUCT
- - FENCING

□ POST



2	07-03-2023	ISSUED FOR PERMIT	5.1.2.e		
1	29-10-86	AS BUILT			
F	10-04-1986	LAUNCHER CANCEL/RELEASED FOR CONSTR.			

REV.	DATE	DESCRIPTION	DRWN	CHK'D	APPR.
LOCATION: WELLSITE GROUW					
WELLS: GRW-02					
TITLE: PLOTPLAN					

REF. No.:			CAD No.: 181-0266		
SCALE: 1:200	SIZE: A1	DRAWING NUMBER: 1-30-GR002-3-32-001	SHEET: 001		