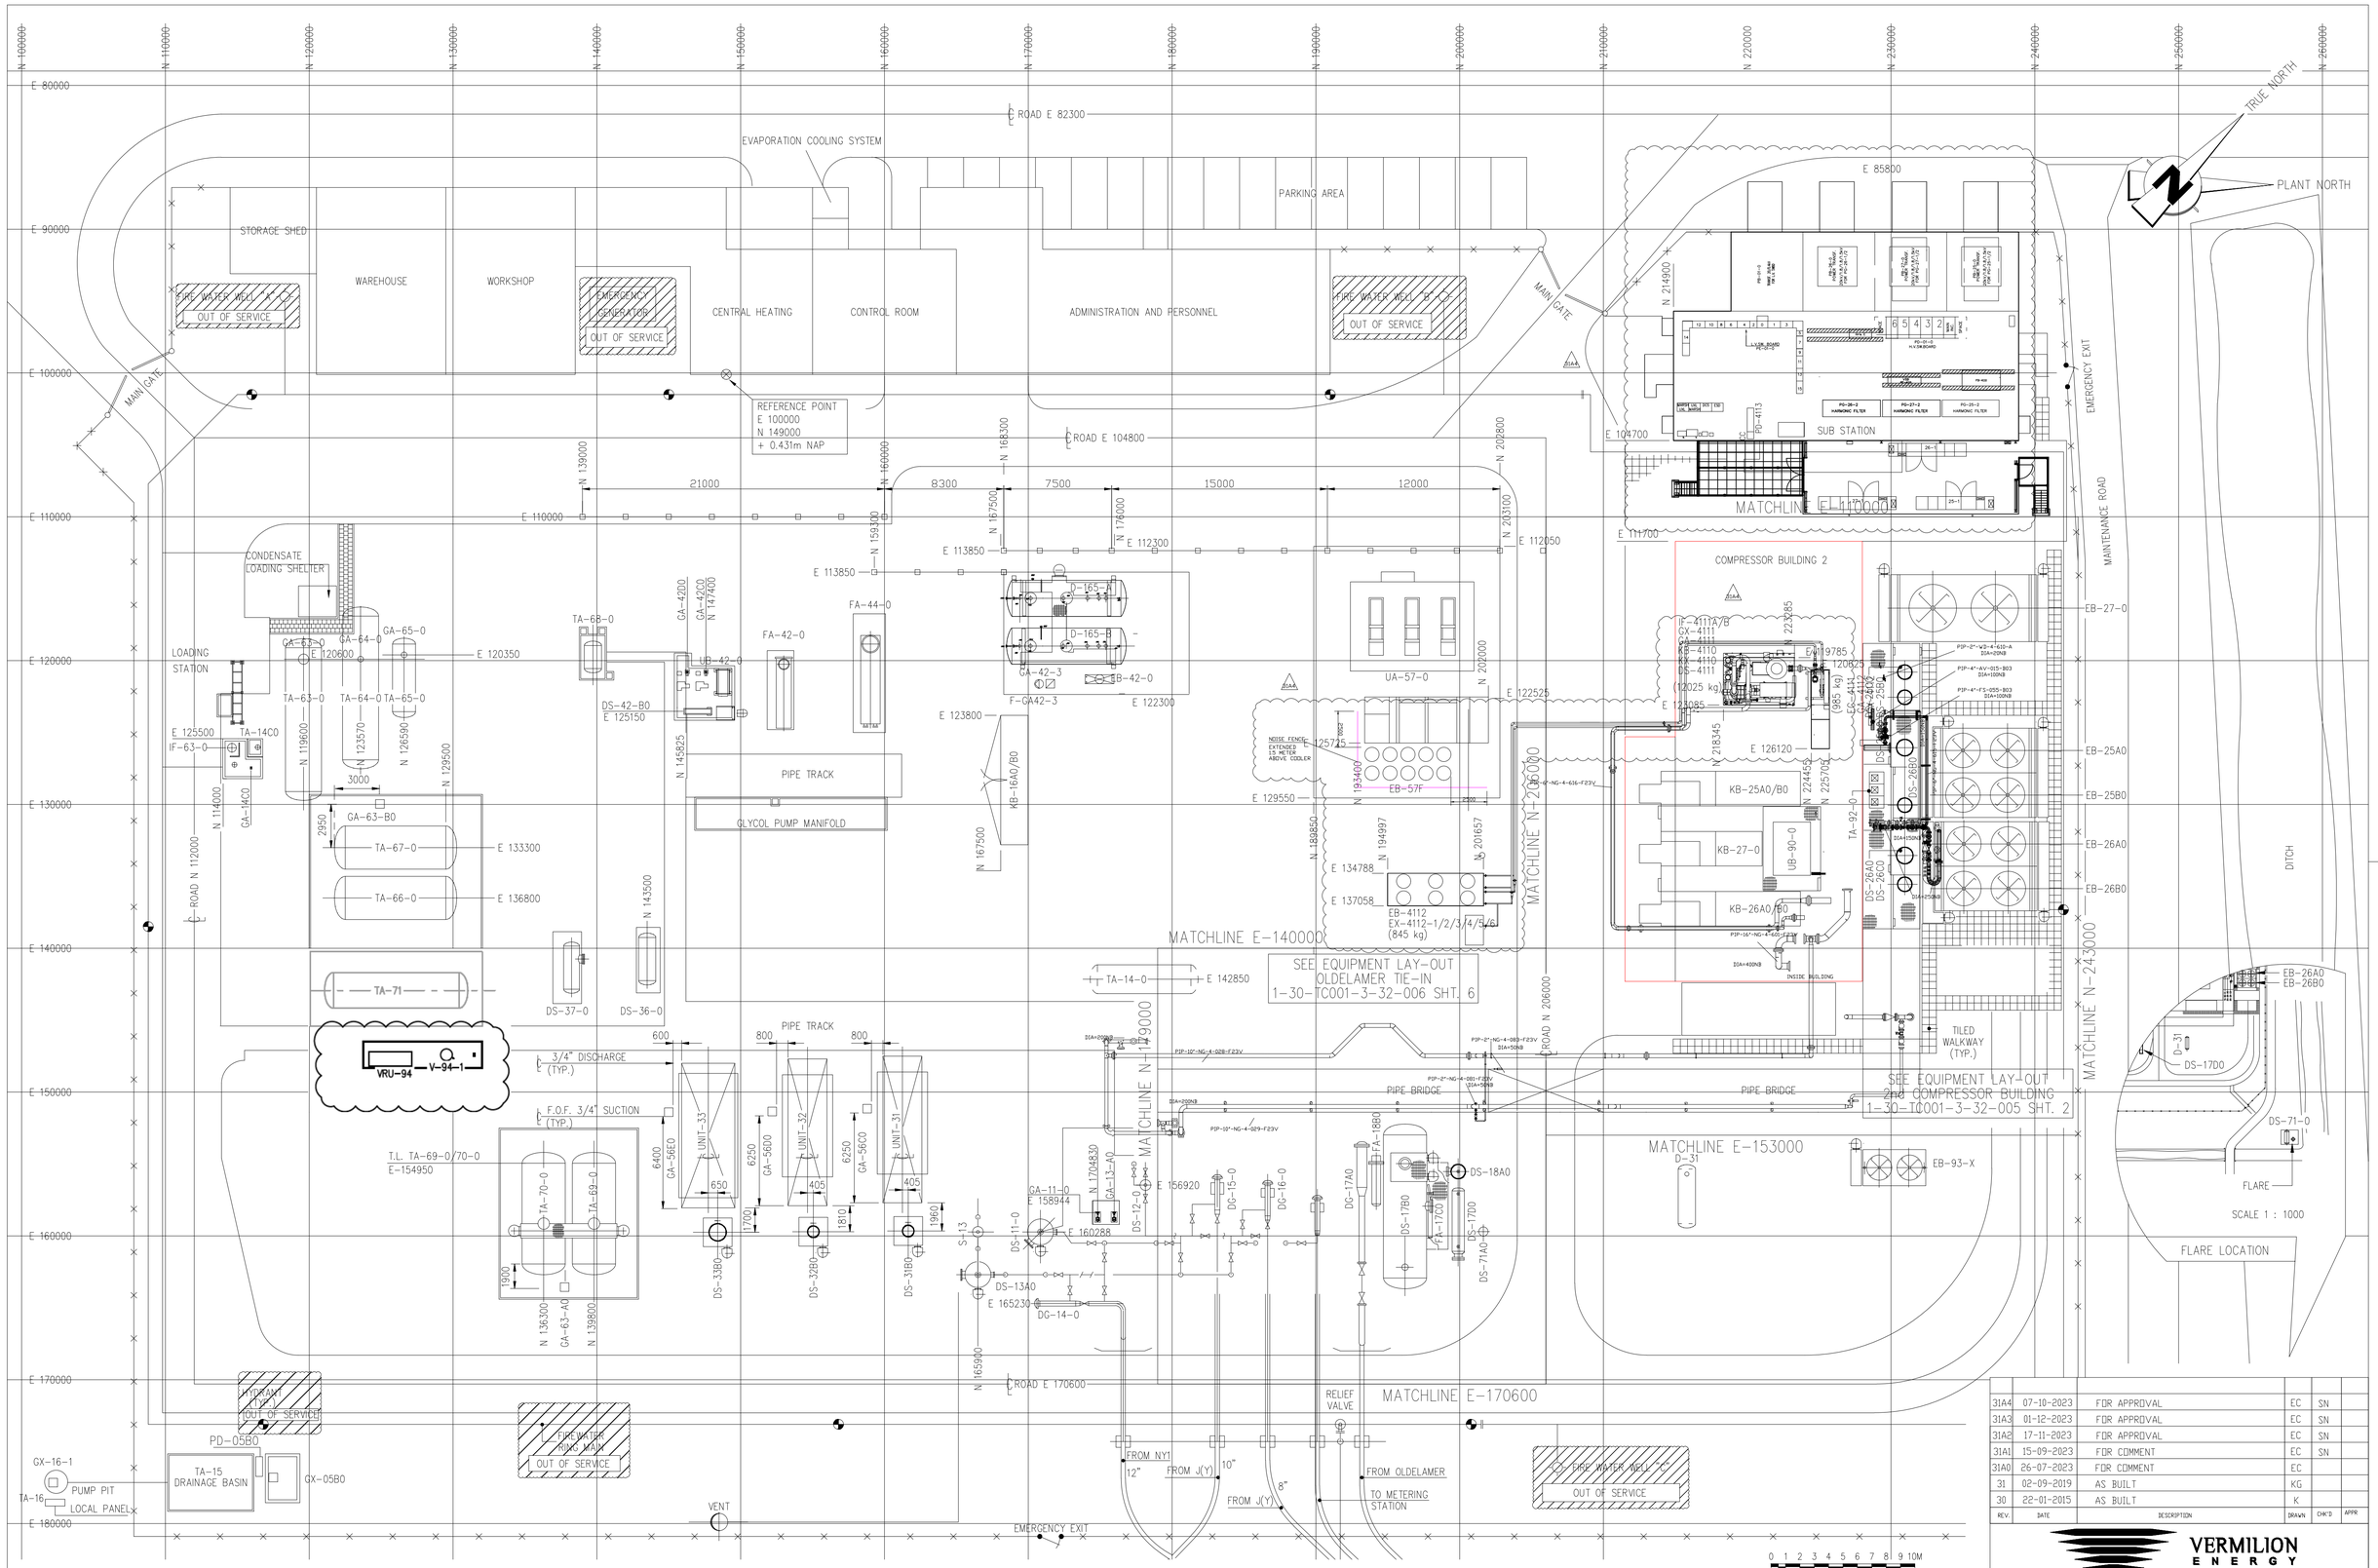

REV.	DATE	DESCRIPTION	DRAWN	CHK'D	APPR
31A4	07-10-2023	FOR APPROVAL	EC	SN	
31A3	01-12-2023	FOR APPROVAL	EC	SN	
31A2	17-11-2023	FOR APPROVAL	EC	SN	
31A1	15-09-2023	FOR COMMENT	EC	SN	
31A0	26-07-2023	FOR COMMENT	EC		
31	02-09-2019	AS BUILT	KG		
30	22-01-2015	AS BUILT	K		

EQUIPMENT No.	DESCRIPTION	EQUIPMENT No.	DESCRIPTION	EQUIPMENT No.	DESCRIPTION	EQUIPMENT No.	DESCRIPTION	EQUIPMENT No.	DESCRIPTION	EQUIPMENT No.	DESCRIPTION	EQUIPMENT No.	DESCRIPTION	EQUIPMENT No.	DESCRIPTION
DG-13A0	INLET SCRUBBER	DS-36-0	CONDENSATE STABILISER	GA-63-0	DISCONNECTED	TA-14-0	INTERMEDIATE SUMP TANK	TA-69-0	CONDENSATE	GA-56D0	OIL RECTIFICATION PUMP	DS-42-B0	REGENERATOR COND. VESSEL	UA-57-0	REFRIGERATION PACKAGE UNIT
DG-14-0	SCRAPER TRAP	DS-37-0	GLYCOL OIL GAS SEPARATOR	GA-64-0	DISCONNECTED	TA-63-0	DISCONNECTED	TA-70-0	RESERVOIR	GA-56E0	OIL RECTIFICATION PUMP	FA-18B0	COND. STABILISER HEATER	EB-57E	AIRCOOLED CONDENSOR
DS-11-0	INLET SCRUBBER	DS-71A0	VENT K.O. DRUM	GA-65-0	DISCONNECTED	TA-64-0	DISCONNECTED	UA-56-0	REFRIGERATION PACKAGE	GA-63-A0	CONDENSATE PUMP	GA-42-C0	REGENERATOR COND. PUMP	EB-93-X	COMPRESSOR LUBE OIL COOLER
DS-12-0	INLET SCRUBBER	EB-56B0	REFRIGERATION CONDENSOR	GA-66A0	DISCONNECTED	TA-65-0	DISCONNECTED	UNIT-31	GAS TREATING UNIT	GA-63-B0	CONDENSATE PUMP	GA-42-D0	REGENERATOR COND. PUMP	KB-4110	GAS COMPRESSOR
DS-31B0	LOW TEMP. SEPARATOR			GA-67A0	DISCONNECTED	TA-66-0	GLYCOL STORAGE	UNIT-32	GAS TREATING UNIT	GX-05B0	DRAINAGE BASIN PUMP	iF-63-0	VAPOUR RETURN FILTER	EB-4112	COMPRESSOR LUBE OIL COOLER
DS-32B0	LOW TEMP. SEPARATOR	FA-42-0	GLYCOL REGENERATOR	KB-16A0	AIR COMPRESSOR	TA-67-0	GLYCOL STORAGE	UNIT-33	GAS TREATING UNIT	GX-16-1	DRAINAGE TRANSFER PUMP	UB-42-0	REGENERATOR CONDENSOR	PB-4110	KB4110 TRANSFORMER
DS-33B0	LOW TEMP. SEPARATOR	FA-43-0	GLYCOL REGENERATOR	KB-16B0	AIR COMPRESSOR	TA-68-0	GLYCOL MAKE-UP TANK	GA-56C0	OIL RECTIFICATION PUMP			TA-14C0	LOADING AREA HOSE DRAIN PIT	PD-02-01	SWITCH GEAR
														GA-11-0	GLYCOL/CONDENSATE PUMP
														GA-13-A0	GLYCOL/CONDENSATE PUMP

GENERAL NOTES

1. EQUIPMENT NUMBERS SHOWN THUS K-23 TO BE DEMOLISHED OR ABANDONED IN PLACE.
2. DIEMENSIONS OF TRANSFORMER IS (AXBXC) 1580x1170x2210 mm

VERMILION ENERGY

LOCATION - GARIJP TREATING CENTRE

TITLE GENERAL PLOTPLAN GAS TREATMENT PLANT FACILITIES

CAD No	DRAWING NUMBER	SHT.
182-0366	1-30-TC001-3-32-001	001