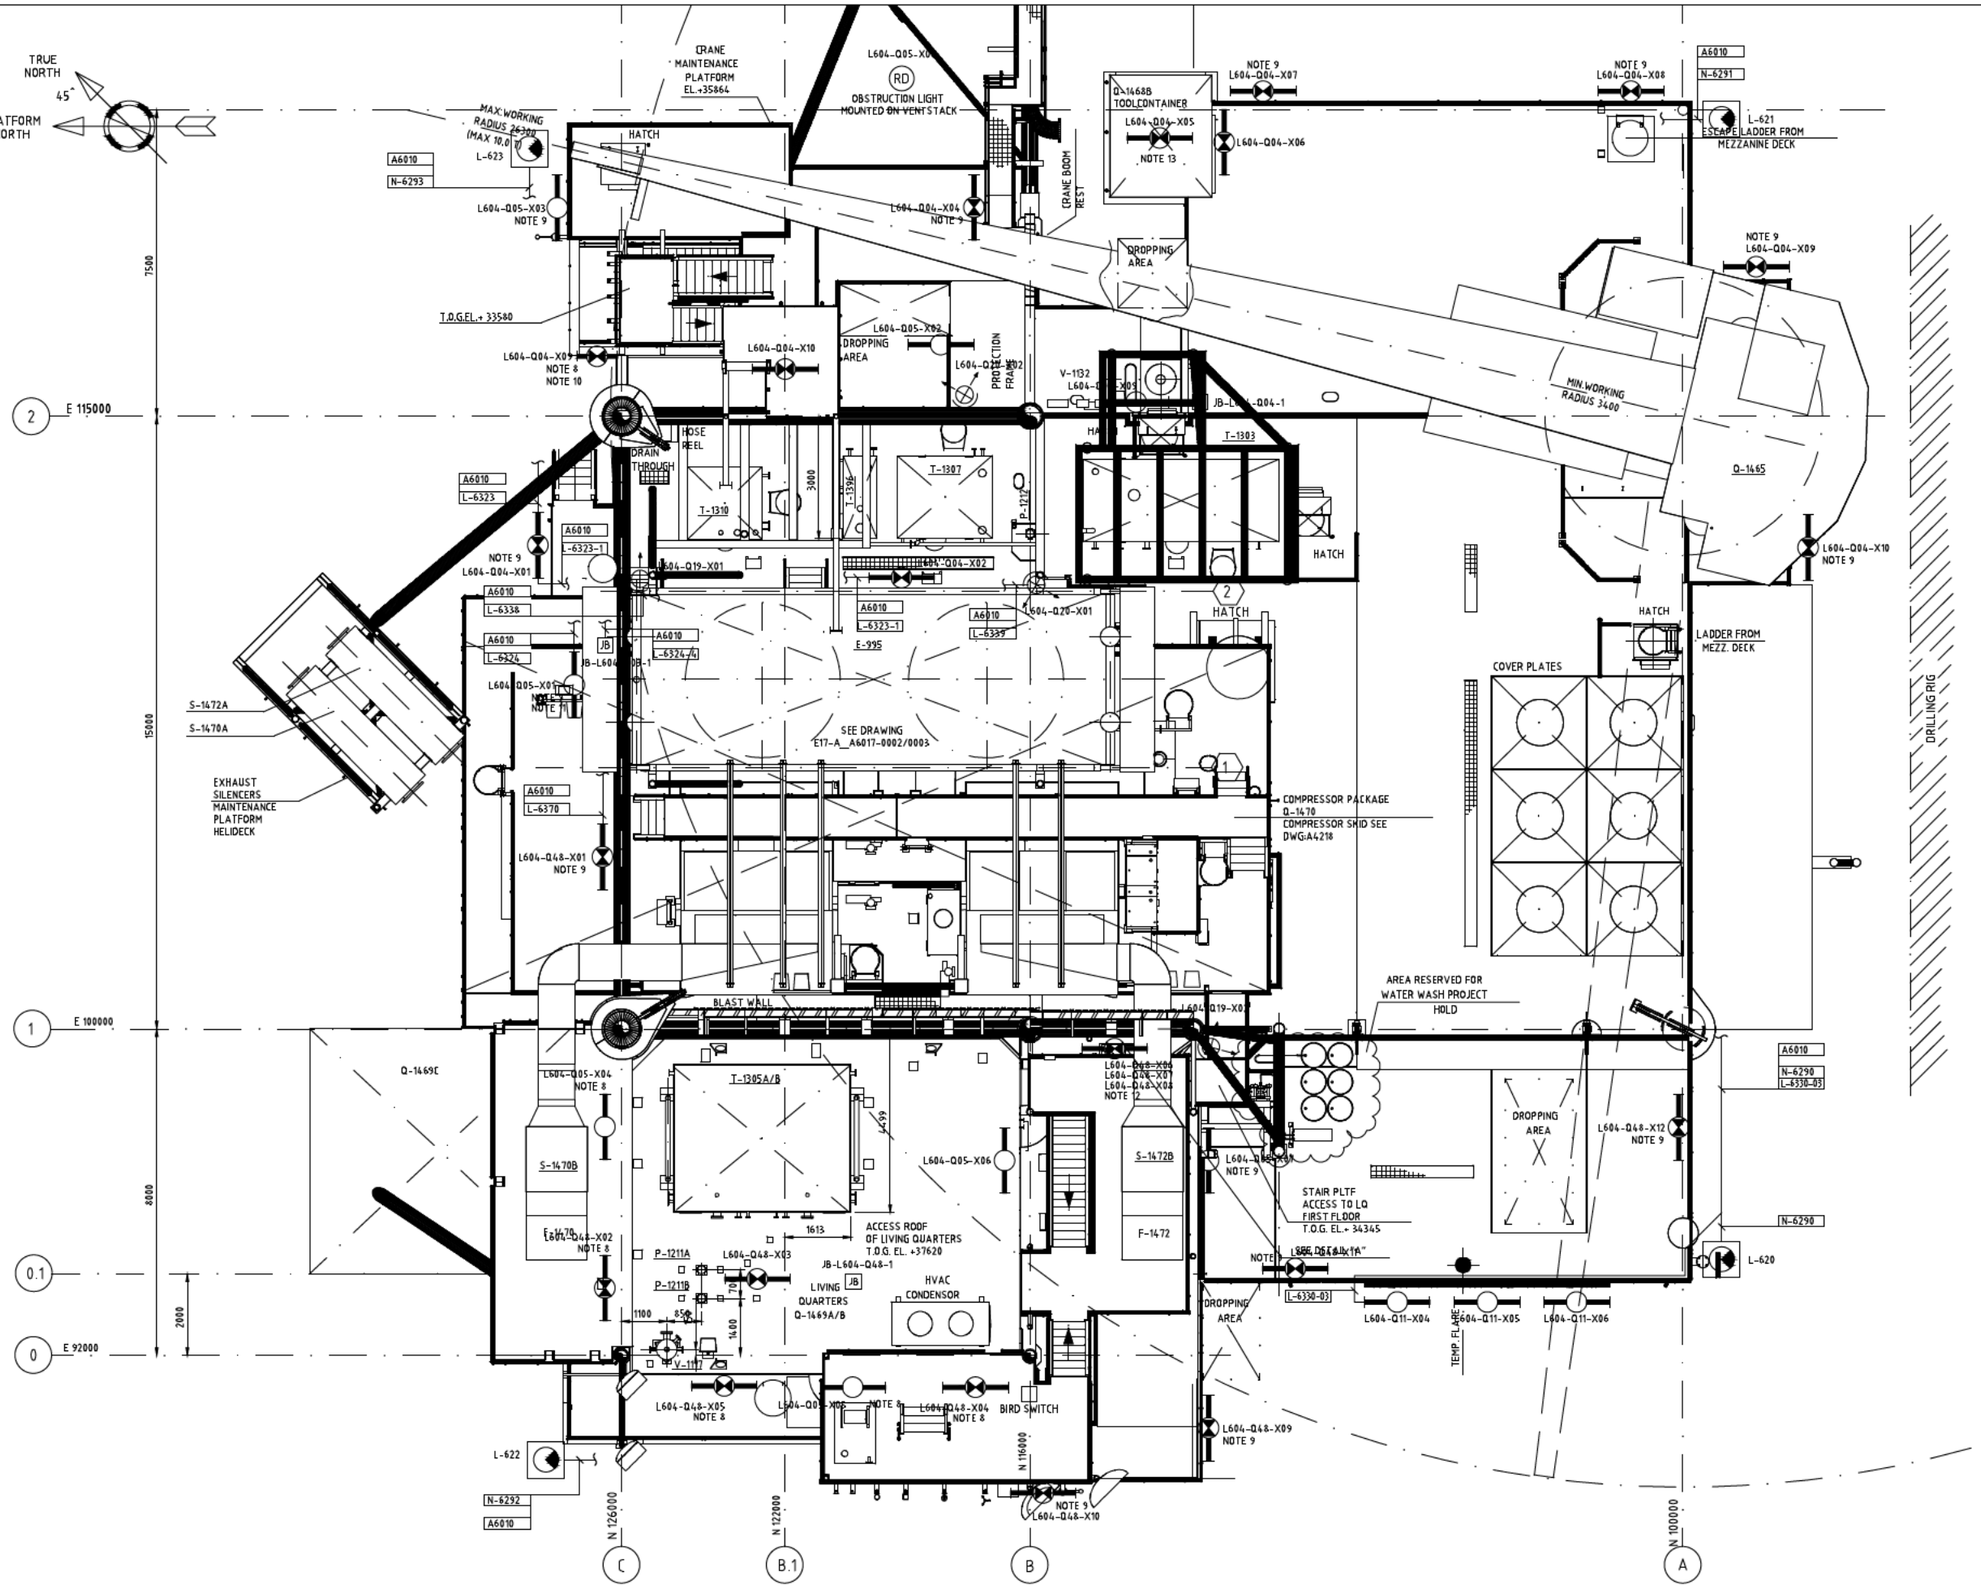


REFERENCE DRAWINGS

DRAWING NO.	DESCRIPTION
694-1	ELECTRICAL CABLE SCHEDULE
A6001	ELECTRICAL LEGEND AND SYMBOLS
A6010	POWER AND EARTHING LAYOUT MAIN DECK
A6035	EARTHING DETAILS
A6065	ONE LINE DIAGRAM NAV. AIDS L-603
A6070	ONE LINE DIAGRAM LTG DB L-604

NOTES

1. ALL LIGHTING FIXTURES, FOR NORMAL AND EMERGENCY LIGHTING, AND FOR ALL CONVENIENCE 230VAC-OUTLETS, ARE FED BY LIGHTING AND SMALL POWER DISTRIBUTION BOARD L-604
2. LIGHTING CIRCUIT FEEDER POINT USED ON LIGHTING LAYOUTS :
   EXAMPLE: L-6324 — CABLE NUMBER; A6017 — REFERENCE TO LAYOUT
3. LIGHTING FIXTURE CODES USED ON LIGHTING LAYOUTS:
   EXAMPLE: 4-Bxx — SEQUENCE NUMBER (determined by installation contractor); FIXTURE IDENTIFICATION CODE; CIRCUIT NUMBER OF DISTRIBUTION BOARD L-604
4. CONVENIENCE OUTLETS CODES USED ON LIGHTING LAYOUTS:
   EXAMPLE: 13-Mxx — SEQUENCE NUMBER (determined by installation contractor); OUTLET IDENTIFICATION CODE; CIRCUIT NUMBER OF DISTRIBUTION BOARD L-604
5. UNLESS OTHERWISE INDICATED, ALL CEILING/WALL MOUNTED LIGHTING FIXTURES ARE MOUNTED APPROX. 2500mm ABOVE FINISHED FLOOR (BOTTOM OF LIGHTING FIXTURES).
6. FIXTURES SHALL BE RELOCATED IN CASE OF CLASHES WITH PIPING AND/OR STRUCTURAL STEEL.
7. NAV. AID EQUIPMENT IS FED FROM L-603 OR L-626
8. WALL MOUNTED
9. HANDRAIL MOUNTED
10. LAMP TYPE B BUT 2x18W
11. ON TOP OF BORDES COOLER BANK
12. FIXTURES PLACED ON THREE (3) DIFFERENT ELEVATIONS IN THE STAIR TOWER.
13. INTERNAL POWER AND LIGHTING CONNECTIONS INSIDE THE TOOLCONTAINER ARE ALSO CONNECTED TO L-604-Q04 CIRCUIT.

LEGEND

DESIGN IS BASED ON THE FOLLOWING :

CODE

A — FLUORESCENT LIGHTING FIXTURE
TYPE:EXCALIBUR VL19E (78W), ATEX II2GD EEx em II T4 WITH Bi-pin LAMPS (2x36W)
MAKE:VICTOR

B — EMERGENCY FLUORESC. LIGHT. FIXT. WITH BATTERY BACK-UP
TYPE:EXCALIBUR VL24E (86W), ATEX II 2GD EEx emd IIC T4 WITH Bi-pin LAMPS (2x36W); EMERG DURATION 3 HOURS.
MAKE:VICTOR

C — EXPLOSIONPROOF OBSTRUCTION LUMINAIRE
TYPE:IQL85 (85W), ATEX-2 II 2GD EEx me II T4; Red glass
MAKE:IMT

D — EXPLOSIONPROOF OBSTRUCTION LUMINAIRE
TYPE:IQL85 (85W), ATEX-2 II 2GD EEx me II T4
MAKE:IMT

E — EXPLOSIONPROOF LUMINAIRE
TYPE:IQL85 (85W), ATEX-2 II 2GD EEx me II T4
MAKE:IMT

F — FLOOD LIGHT
TYPE:FL40 SA (400W), LAMP TYPE: H.P. SODIUM EXPL-PROOF EExde IIB T3
MAKE:IMT

G — E — EMERGENCY EXIT TRITIUM LIGHTING (21VA)
TYPE:-
MAKE: PCH b.v. NL.

K — EXPLOSIONPROOF SEARCH LIGHT
TYPE:FL270 (W), EEx de IIB T3; 24Vd-A; HALOGEN LAMP (2x70W)
MAKE:IMT

L — NAVIGATION AIDS LANTERN
TYPE:L303 Ex-M
MAKE:ORGA

REV:	DATE	BY:	DESCRIPTION:	CHK'D:	APP'D
05	01.05.25	JLA	AS BUILT (1104948)	TBR	JRU
4	30.03.18	SJO	AS BUILT (WO 480550)	TBR	EVB
3	17.02.17	POC	AS BUILT (WO 418334)	JHO	EVB
2	23.08.16	MRO	AS BUILT (WO 646951)	LPO	EVB
1	12.04.13	OCA	AS BUILT (WO 486363)	BRIJ	WLI

ENI ENERGY NETHERLANDS B.V. — SECTION NO. —

PLATFORM: L7-F

TITLE: LIGHTING AND NAV. AIDS LAYOUT MAIN DECK

—

SCALE:	DRAWING No.:	SHEET No.:	SIZE
1:75	A6017	0001	A1
JOB No.:			REV 05

PRINTED: 01 MAY 2025 BY: 5.1

FILE NAME: OP\L7-F\E17-A_A6017-0001_05_AB_2025-05-01_01.DWG